
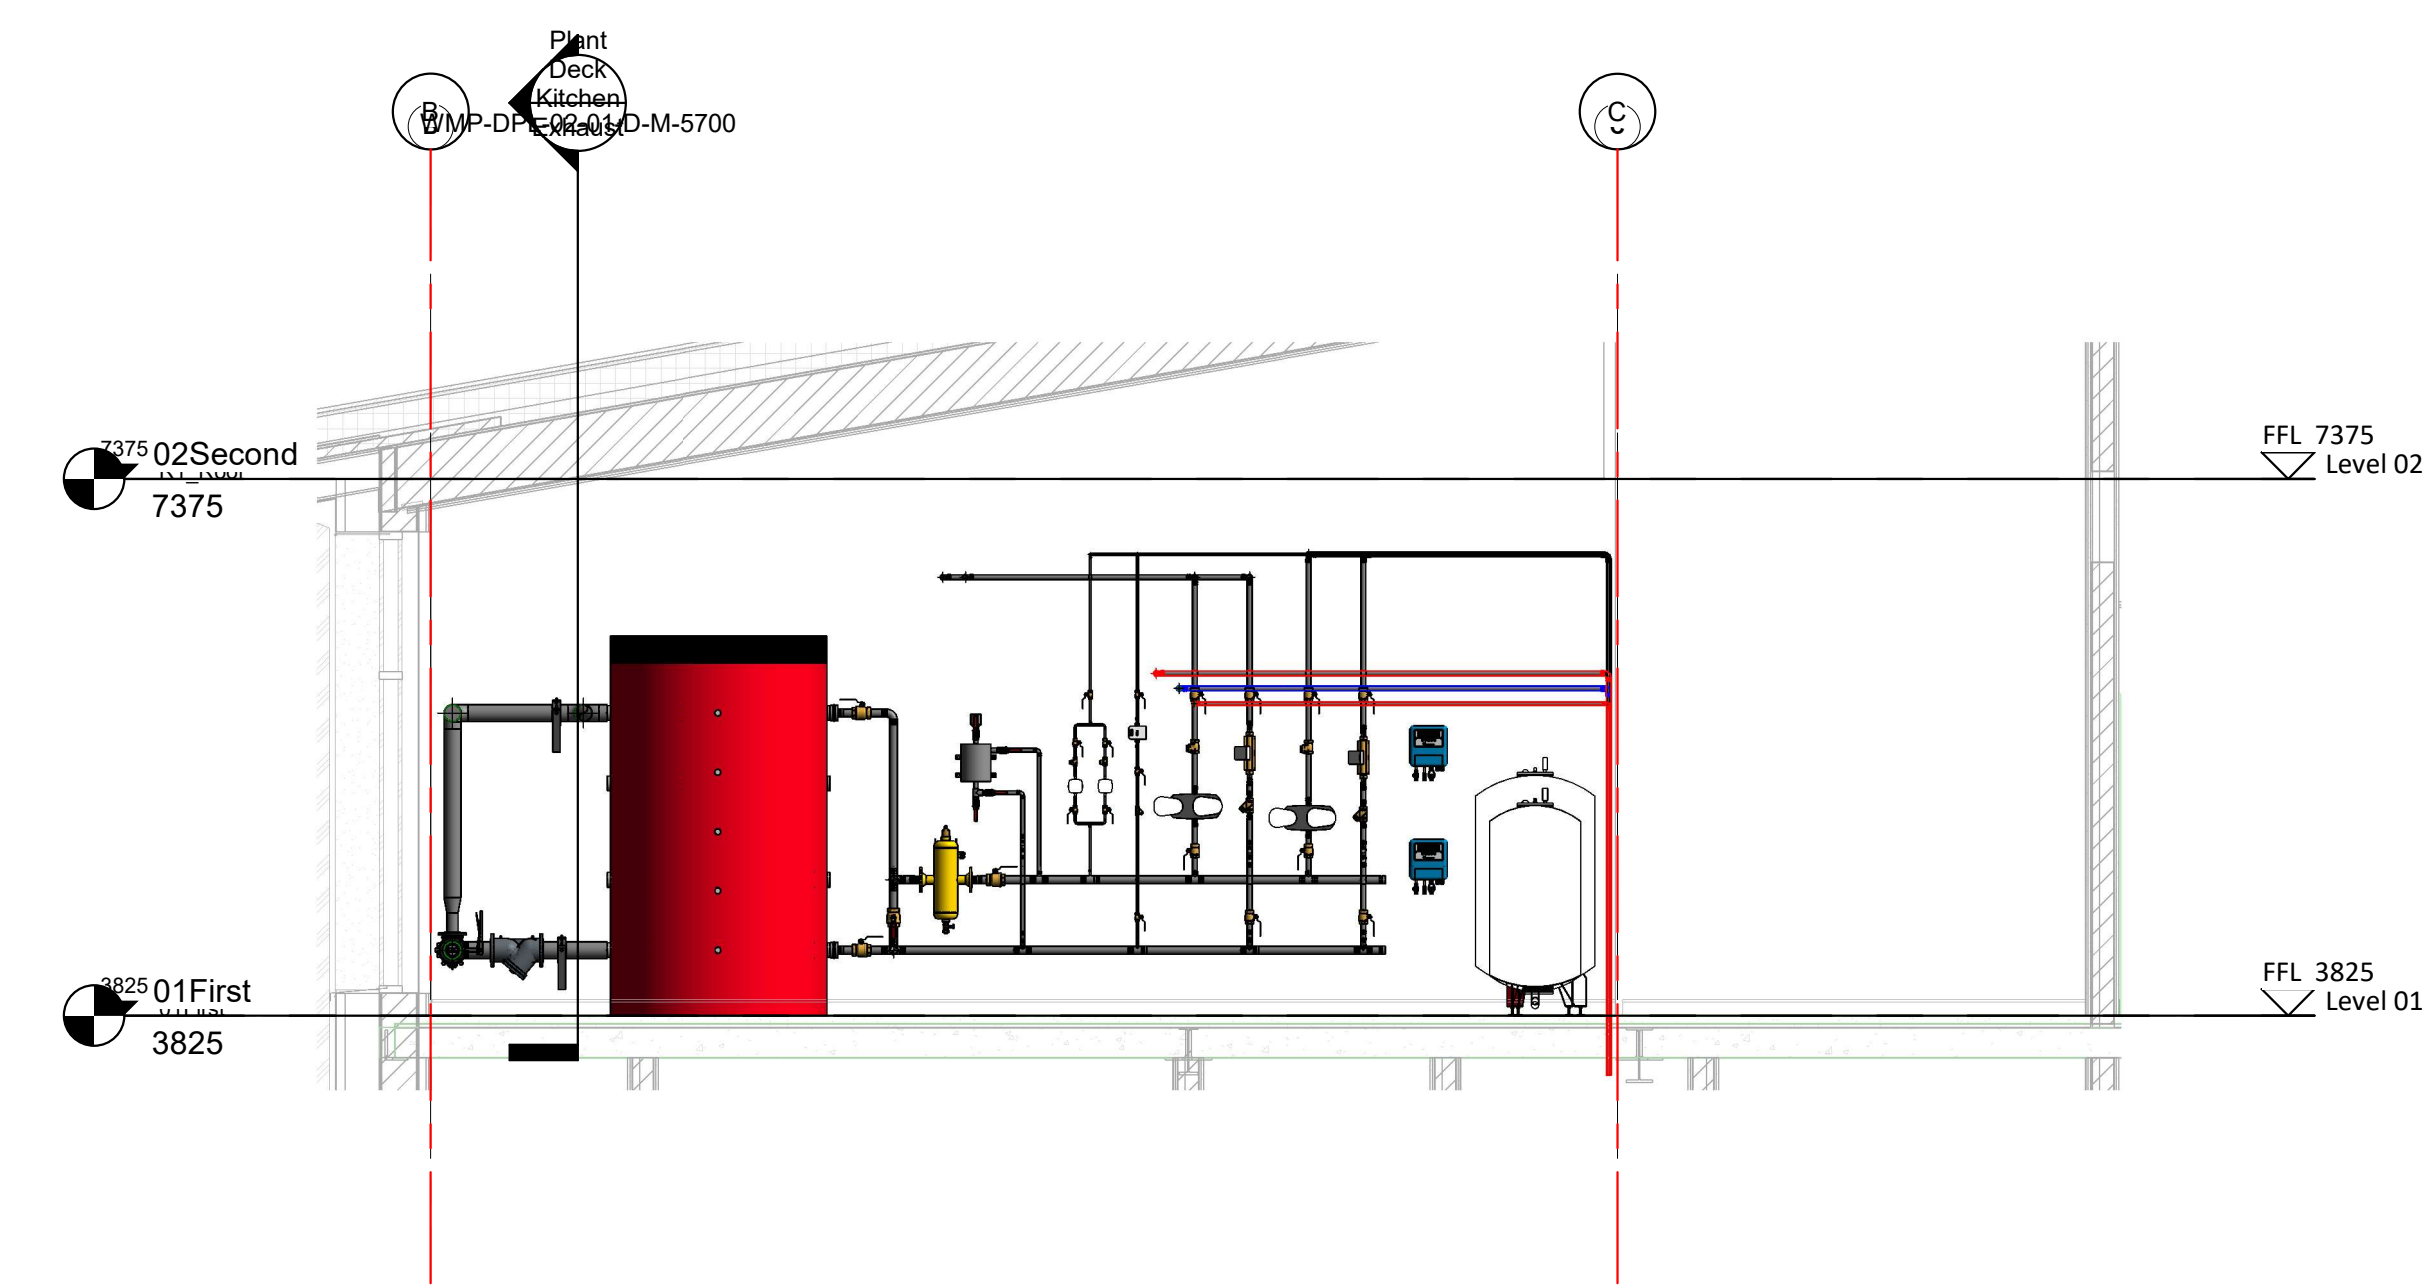
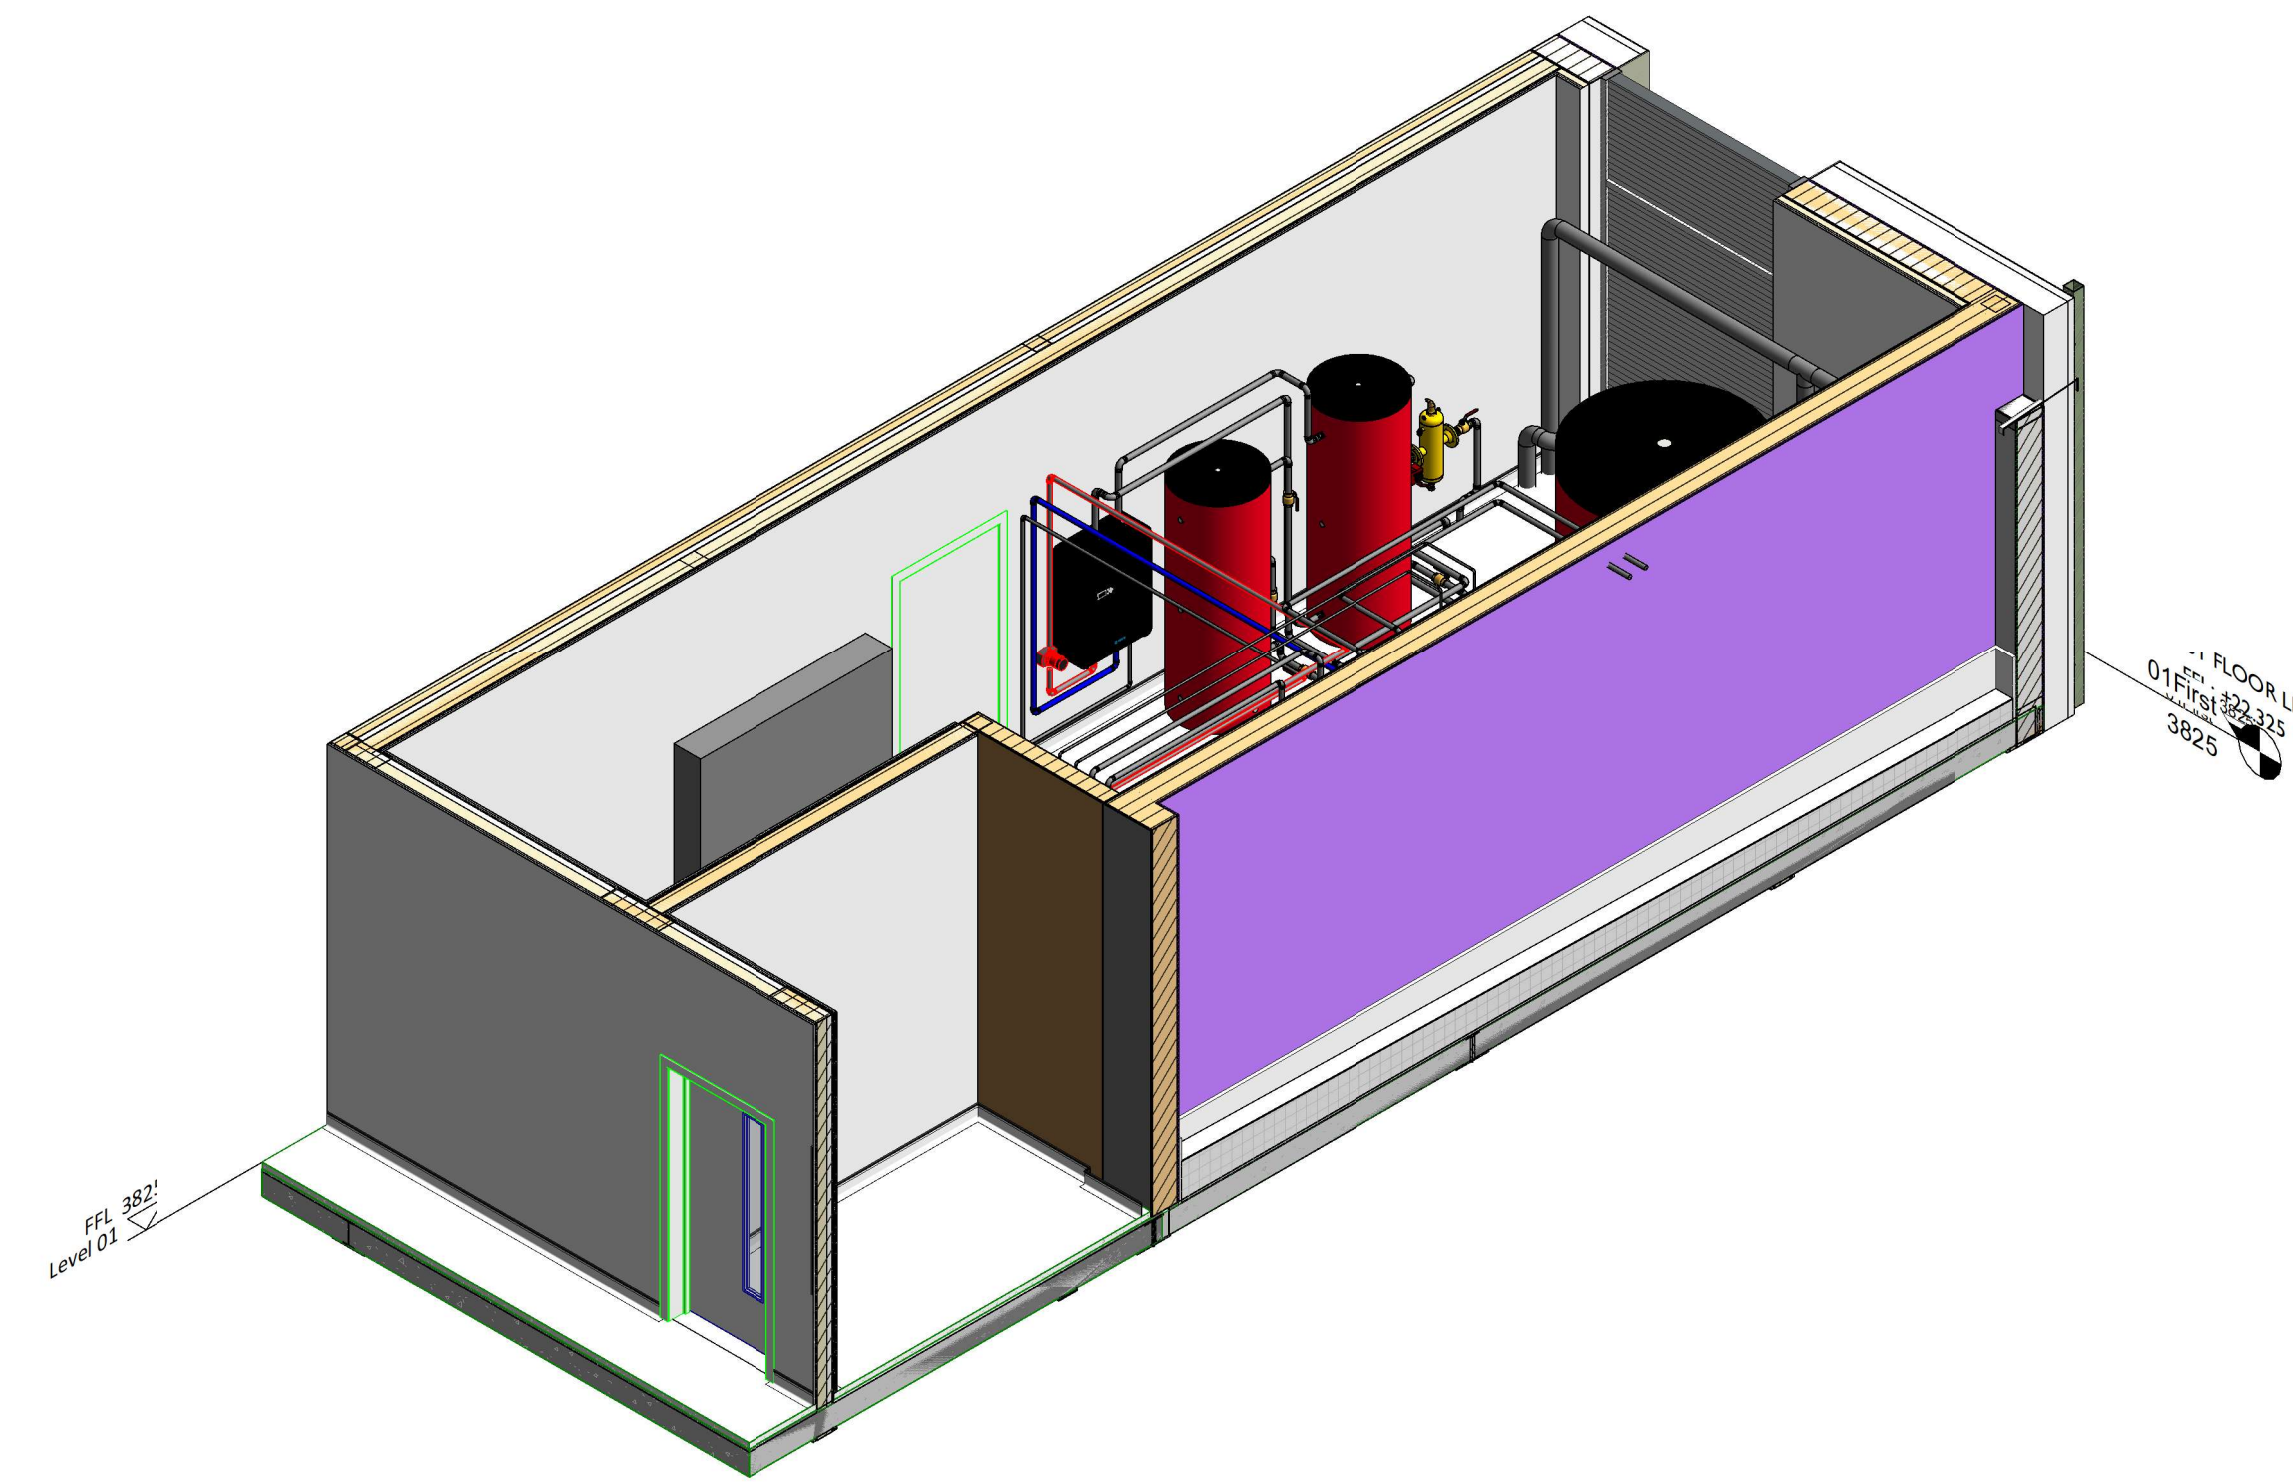
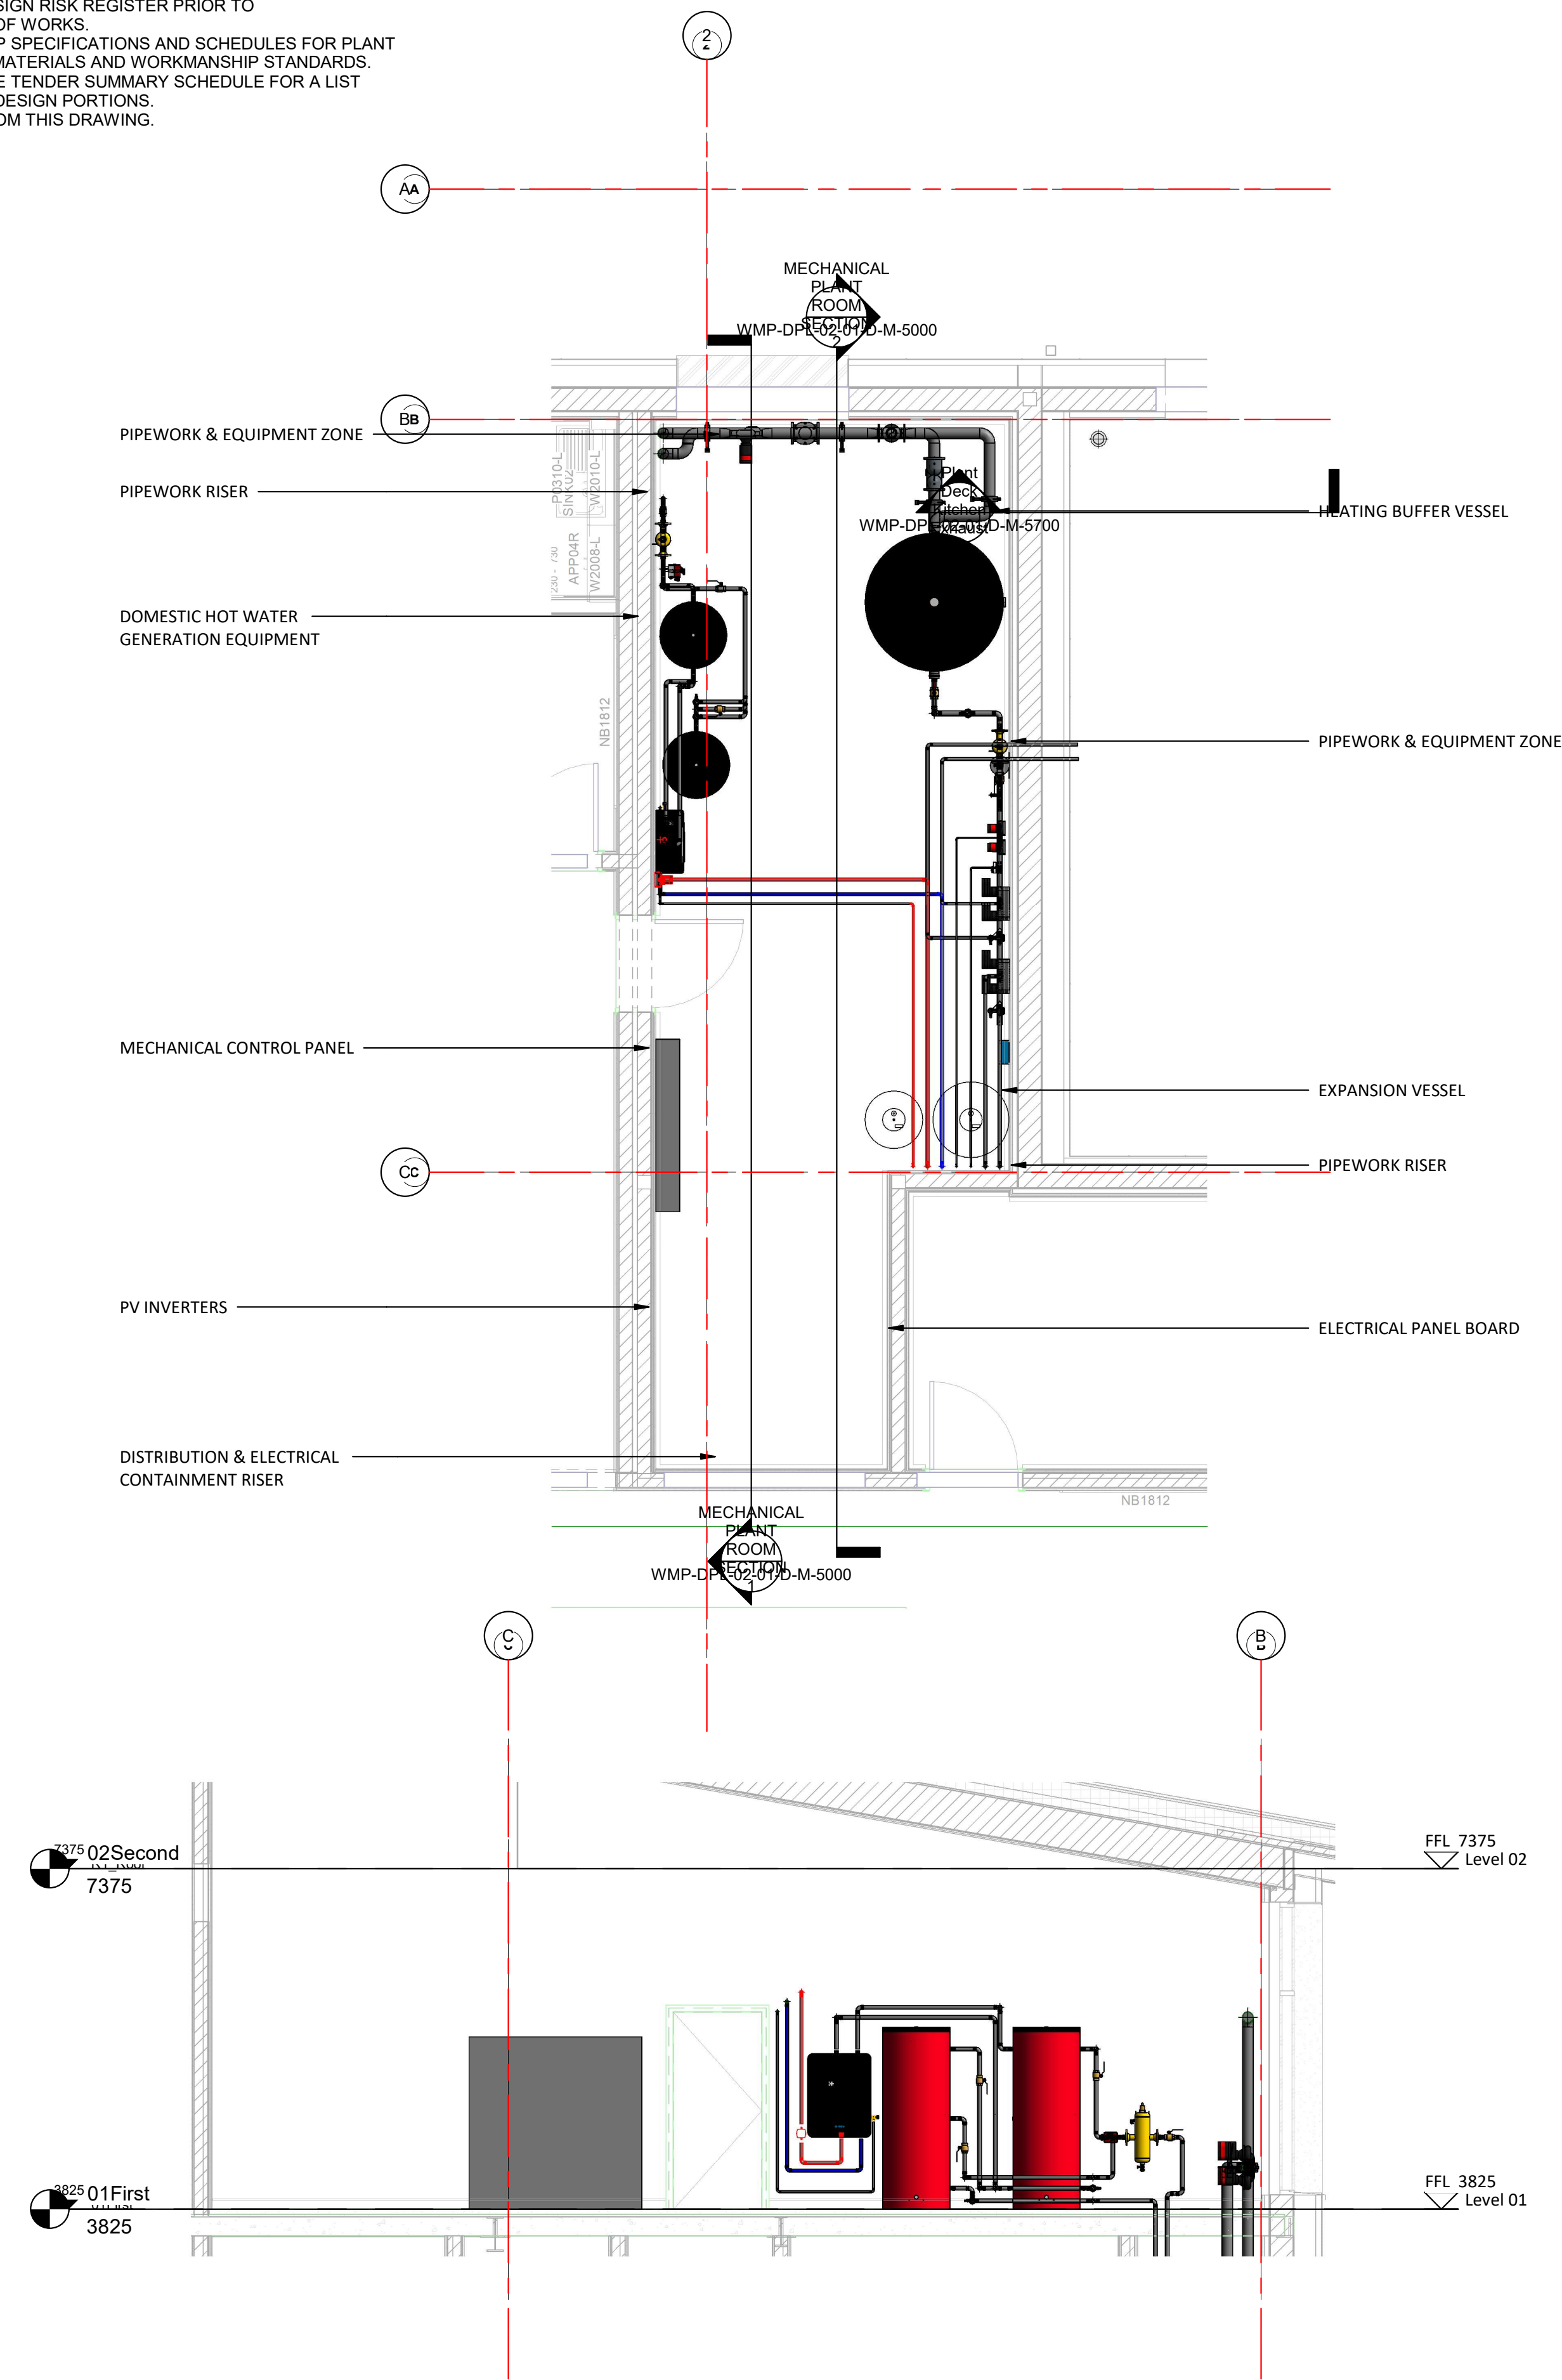



- MEP GUIDANCE NOTES:**
1. REFER TO THE M&E DOCUMENT ISSUE SCHEDULE FOR A FULL LIST OF MEP DOCUMENTS APPLICABLE TO THIS PROJECT.
 2. REFER TO THE DESIGN RISK REGISTER PRIOR TO COMMENCEMENT OF WORKS.
 3. REFER TO THE MEP SPECIFICATIONS AND SCHEDULES FOR PLANT SPECIFICATIONS, MATERIALS AND WORKMANSHIP STANDARDS.
 4. REFER TO THE M&E TENDER SUMMARY SCHEDULE FOR A LIST OF CONTRACTOR DESIGN PORTIONS.
 5. DO NOT SCALE FROM THIS DRAWING.

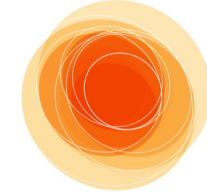

 DAVIES PARTNERSHIP <small>ENGINEERING ARCHITECTURE</small>	This drawing was prepared by Davies Partnership for the benefit of our client pursuant to a contract which limits the purposes for which the drawing may be used. Davies Partnership retains the copyright. Do not scale from this drawing.	Revision	Status	Date	Description	By	Checked	Client: READ CONSTRUCTION / FLINTSHIRE COUNTY COUNCIL	Project Title: NEW WM PRIMARY SCHOOL, OAKENHOLT	Drawing Title: MAIN SCHOOL PLANT ROOM	Project No: 22106	Scale: 1:50	Paper Size: A1
		IP04	SS	2024-02-02	ISSUED FOR STAGE 5 APPROVAL	MKR	RL						
		CD3	AS	2024-06-17	STAGE 5 APPROVED	MKR	RL						
		CD4	A6	2025-09-05	AS CONSTRUCTED	GB	RL						
 daviesspartnership.co.uk													